WISCONSIN INTERSTATE NETWORK
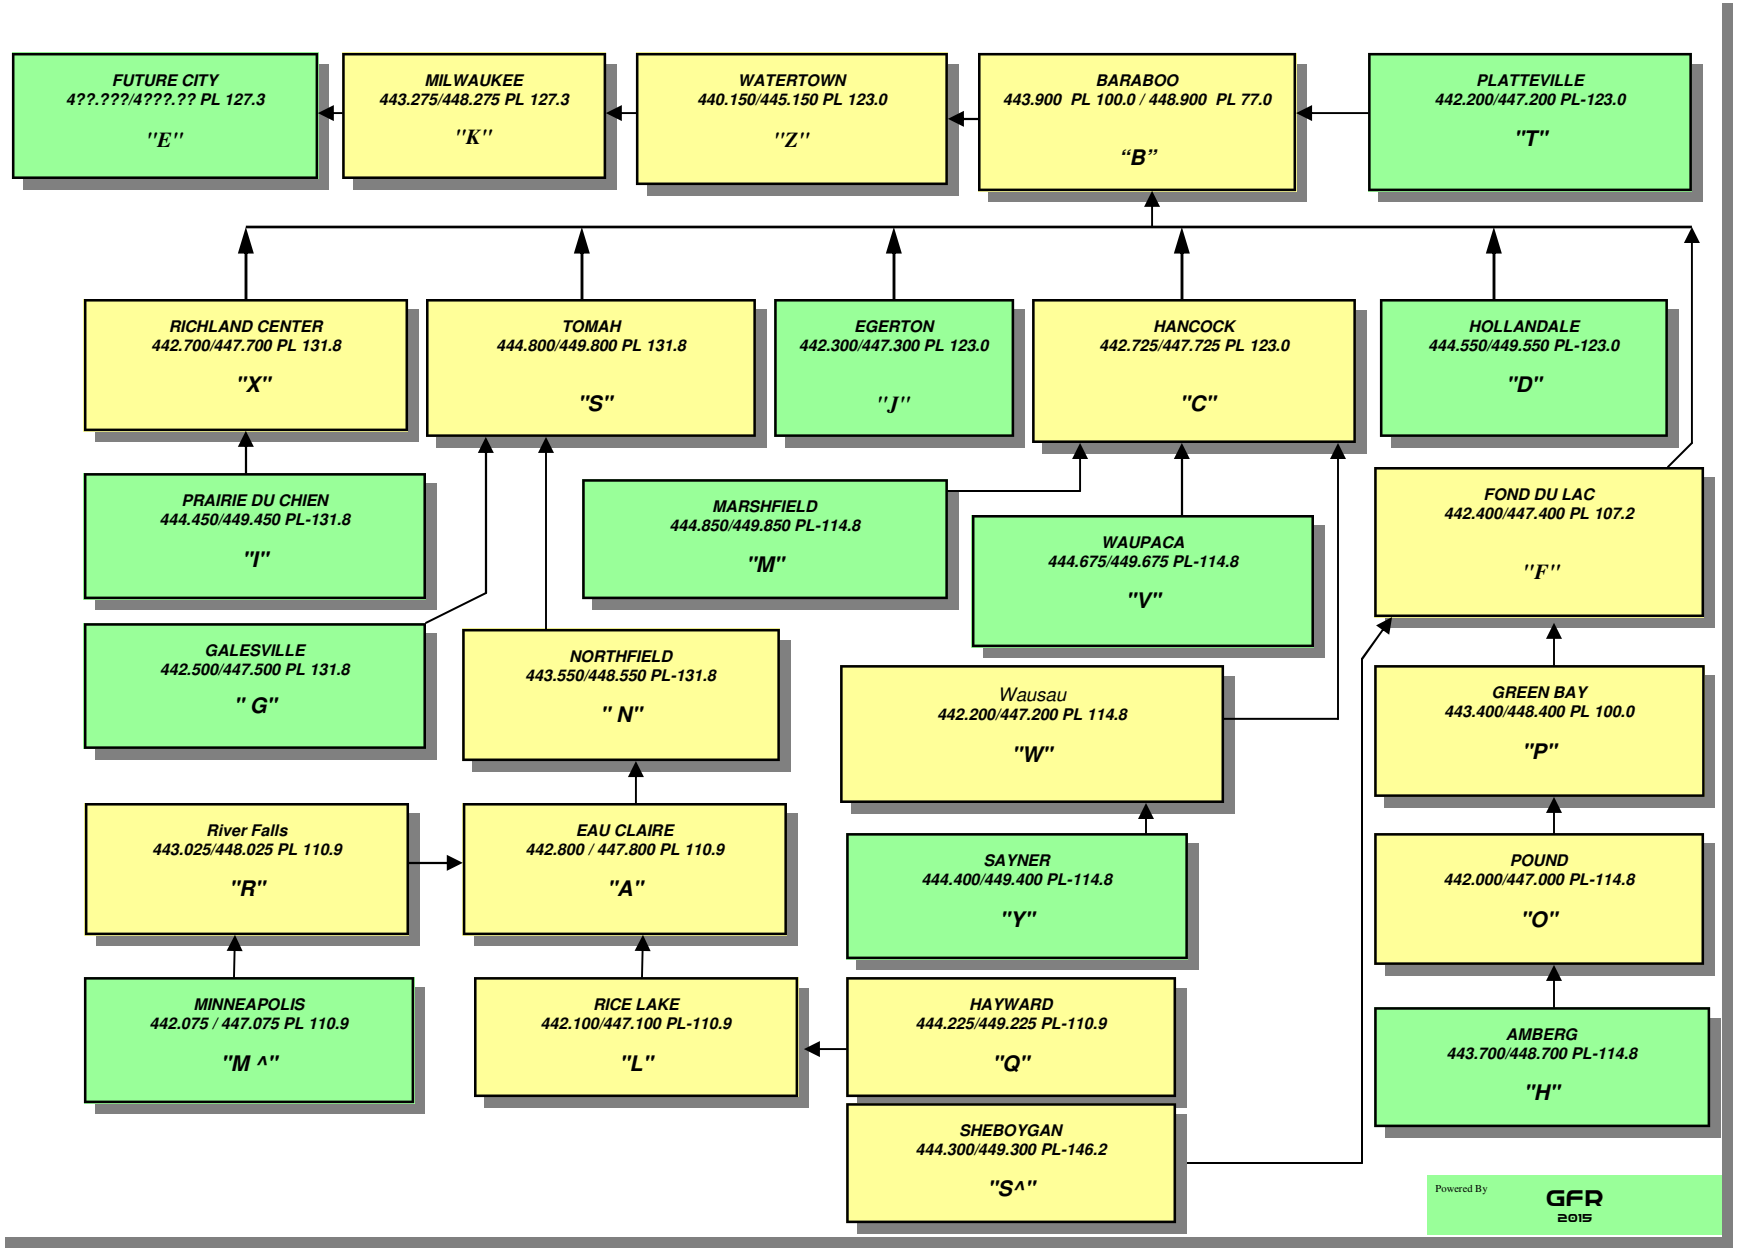
AS-BUILT
11-2015